


BUILDING INDEX		
I.D. No.	BUILDING	PLAN No.
B0533A	TRAVEL INFORMATION CENTRE.	3607 - 81
T0297	STAFF ACCOMMODATION UNIT	3607 - 81
T0388	STAFF ACCOMMODATION	002278-87
T0537	STORAGE BUILDING	----

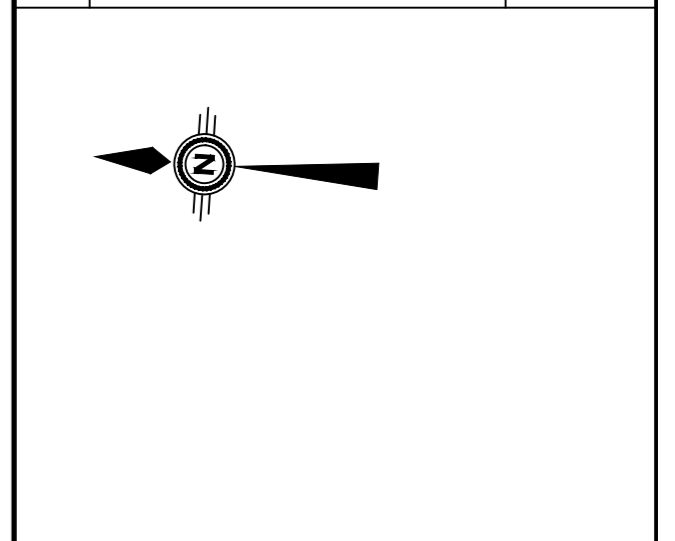

LEGEND	
[Cross-hatched pattern]	BUILDING
[Dotted pattern]	GRAVEL
[Stippled pattern]	CONCRETE
[Diagonal lines]	PAVING STONE
[Dashed line]	PROPERTY LINE AND EASEMENT LINE
[Dotted line]	IRON PIN AND FOUND IRON PIN
[Solid line]	CONCRETE CURB
[Line with 'W']	CONCRETE DROP CURB
[Line with 'W']	WATER LINE
[Line with 'F.H. S']	FIRE HYDRANT AND GATE VALVE
[Line with 'C.C. W']	CURB STOP (COCK)
[Line with 'W']	200 mm P.V.C. SANITARY SEWER LINE
[Line with 'R']	200 mm CONC. STORM SEWER LINE
[Circle]	MANHOLE
[Circle with 'R']	CATCH BASIN (TOP INLET)
[Circle with 'C']	CATCH BASIN (SIDE INLET)
[Line with 'G']	150 mm M.P. NATURAL GAS LINE AND VALVE
[Line with 'OP']	OVERHEAD POWER LINE
[Line with 'UP']	UNDERGROUND POWER LINE AND MANHOLE
[Line with 'UT']	UNDERGROUND TELEPHONE LINE AND MANHOLE
[Line with 'OT']	OVERHEAD TELEPHONE LINE
[Line with 'OPT']	OVERHEAD POWER AND TELEPHONE LINES
[Line with 'UPT']	UNDERGROUND POWER AND TELEPHONE LINES
[Line with 'AL']	AREA LIGHT, STREET LIGHT AND POWER POLE
[Line with 'S.L. UP']	GUY WIRE
[Line with 'P.P. UP']	CAR PLUG-IN POSTS
[Line with 'P.P. UP']	TRANSFORMER
[Line with 'B. TRANSF. UP']	TRANSFORMER ON POWER POLE
[Line with 'RED. UP']	TELEPHONE PEDESTAL
[Line with 'UTV']	UNDERGROUND TELEVISION CABLE
[Line with 'OTV']	OVERHEAD TELEVISION CABLE
[Line with 'B.P. UP']	ABANDONED UTILITIES
[Line with 'B.P. UP']	BUMPER POST
[Line with 'X']	FENCE
[Line with 'X']	GATES
[Line with 'X']	CULVERT (CORRUGATED METAL PIPE)
[Line with 'X']	300 mm C.M.P.
[Line with 'X']	CONFEROUS TREE
[Line with 'X']	DECIDUOUS TREE
[Line with 'X']	BUSH / BRUSH
[Line with 'X']	HEDGE

SITE DATA

ADDRESS :
 LEGAL DESCRIPTION : PARCEL E, PLAN 83 B 01559,
 S.E. 1-50-28-W3M,
 AREA : .939 ha., (2.32 ac)

LAST SITE VISIT :

DATE	BY	DESCRIPTION	STATUS
SEPT/99	R.R.	UPDATE PLAN	
JULY/98	S.S.	ADDED POWER FROM TRANSF. NORTH	
AUG/90	L.C.	ROAD WIDENING SHOWN ON PLAN	
APR/97	R.R.	UPDATE PLAN, ADD STORAGE BLDG. NO.	D.W.
NOV/96	R.R.	SCANNED AND CONVERTED TO AUTOCAD BY SCANTECH	R.R.

Government of Alberta		SITE RECORD PLAN
Infrastructure		
		TECHNICAL SERVICES BRANCH
		FACILITY EVALUATIONS

LLOYDMINSTER -
 TRAVEL INFORMATION CENTRE.

SCALE : 1: 300	DRAWN BY : A. MAKARUK	SITE NUMBER
DATE : NOV. 1985	CHECKED BY :	S0553
THIS IS A REPRODUCTION FROM THE DEPARTMENT'S RECORDS. NO WARRANTY OR REPRESENTATION AS TO THE COMPLETENESS OR ACCURACY OF INFORMATION HEREON IS MADE.		